



City & County
of San Francisco

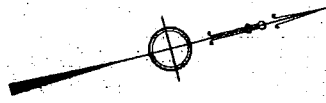

MAP OF
BLOCKS 3257, 3258 AND 3259
OF
BALBOA TERRACE ADDITION
SAN FRANCISCO
CALIFORNIA
SCALE 40 FEET TO 1 INCH
PUNNETT & PAREZ ENGINEERS
Sept. 1924
SHEET No 2.
OFFICE COPY

NOTE: The Easements 15 feet wide shown upon this Map are intended for the purpose of rights and access to and from the lots shown upon this Map and also for Sewers and Public Service Lines.

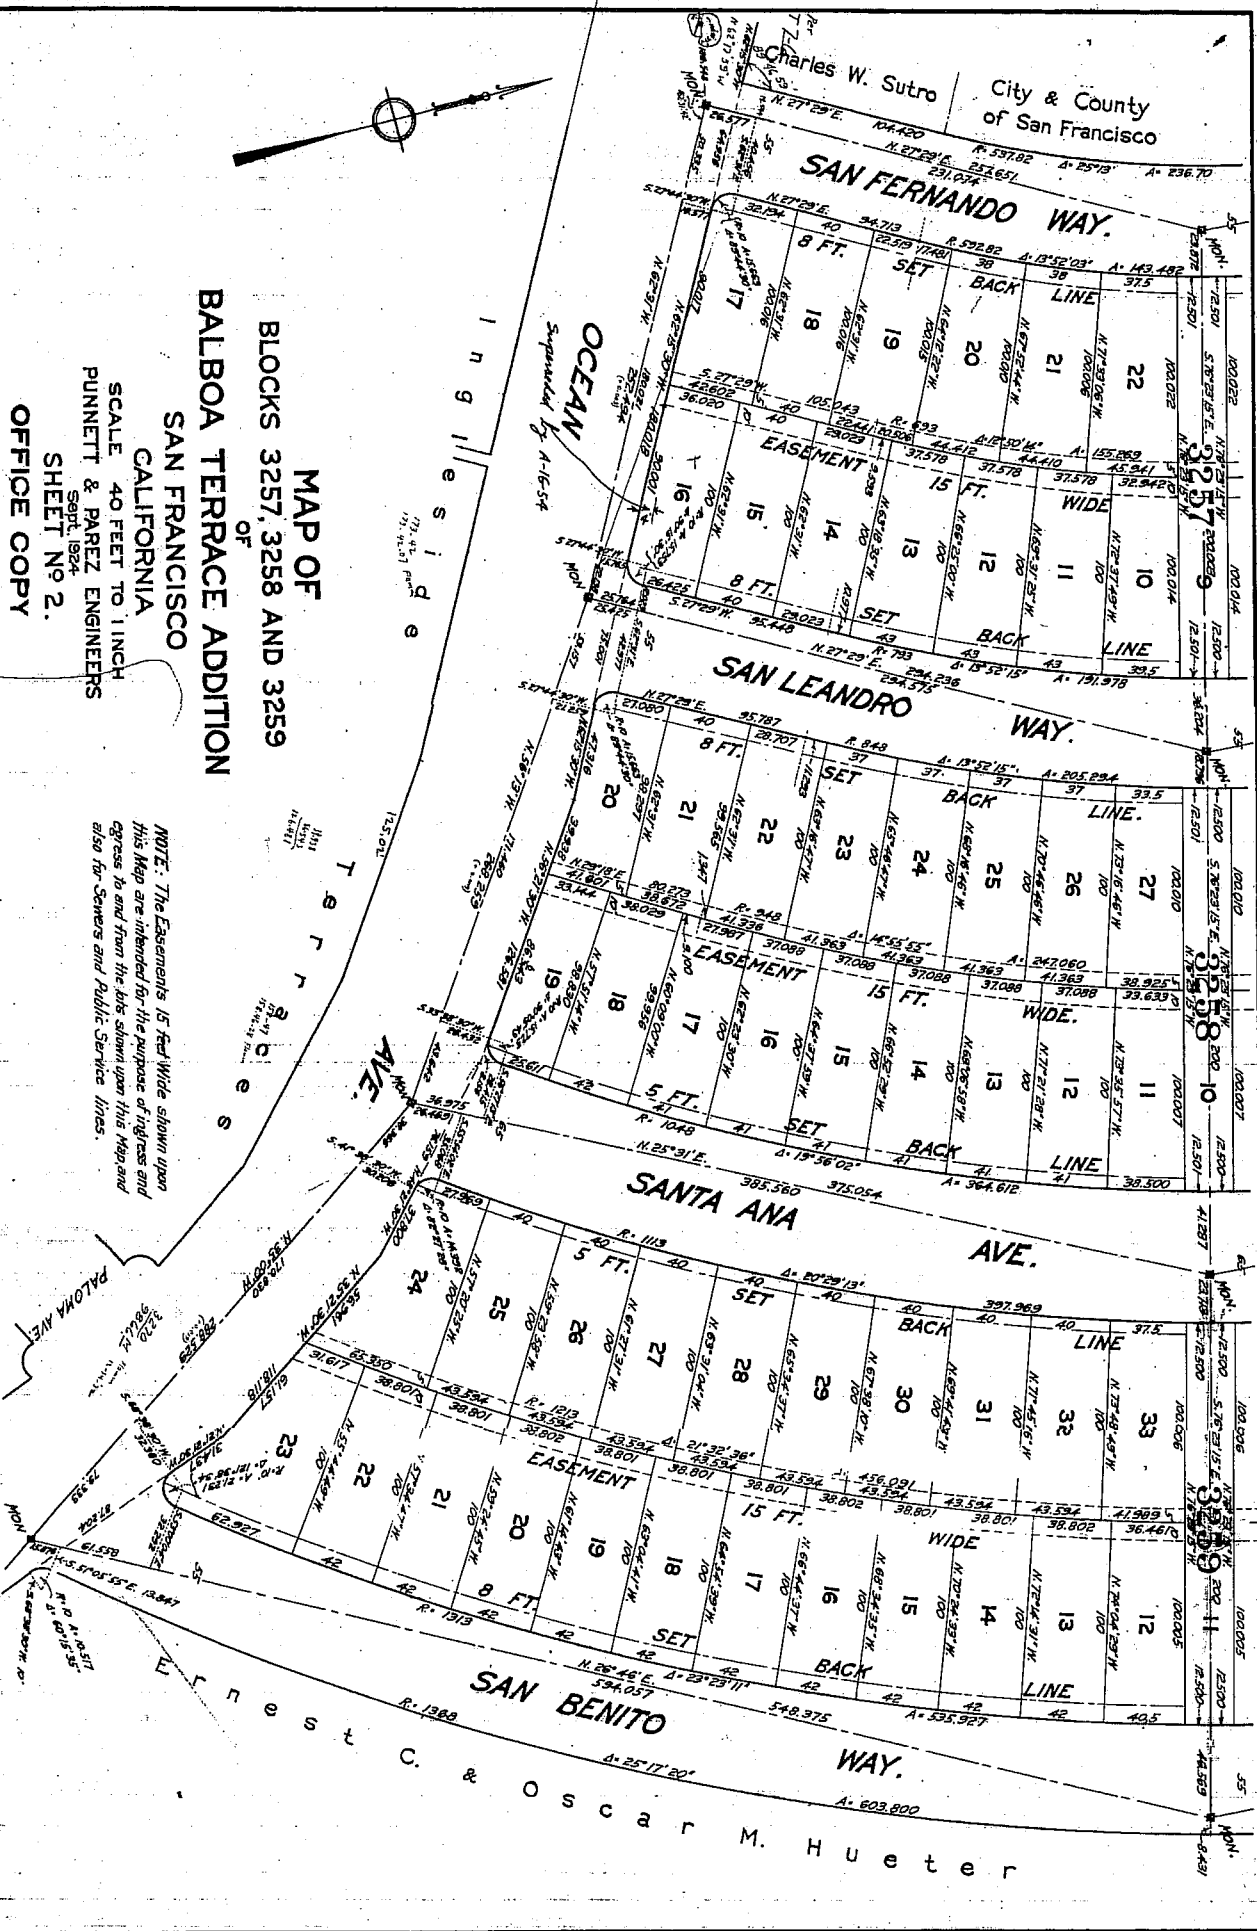


OFFICE COPY

CITY ENGINEERS OFFICE
CITY PROPERTY
SAN FRANCISCO


OFFICE COPY
MAP OF
BLOCKS 3260 TO 3269 INCL.
BALBOA TERRACE ADDITION
SAN FRANCISCO
CALIFORNIA

SCALE 40 FEET TO 1 INCH
PUNNETT, PAREZ & HUTCHISON
CONSULTING ENGINEERS
58 SUTTER ST. S.F. CAL.
JULY, 1926.
SHEET NO. 4.

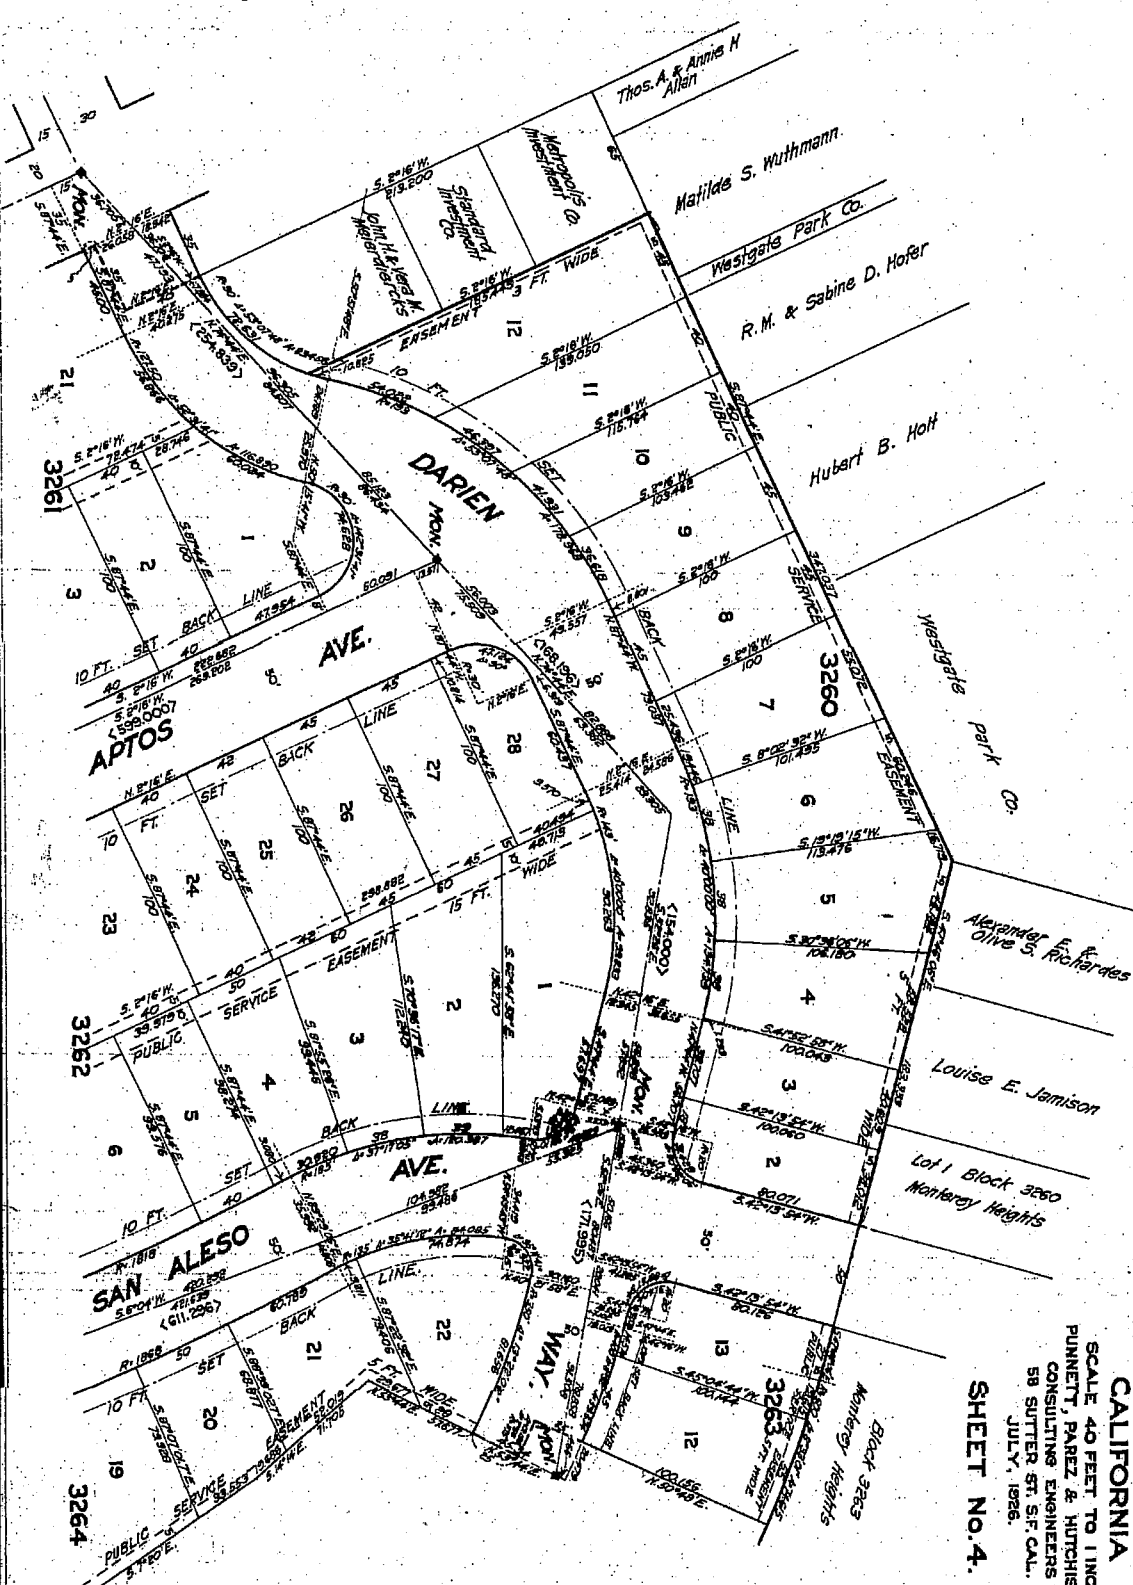

M. T. DAVIDSON MANOR

BLOCK 3259 BALBOA TERRACE ADDITION

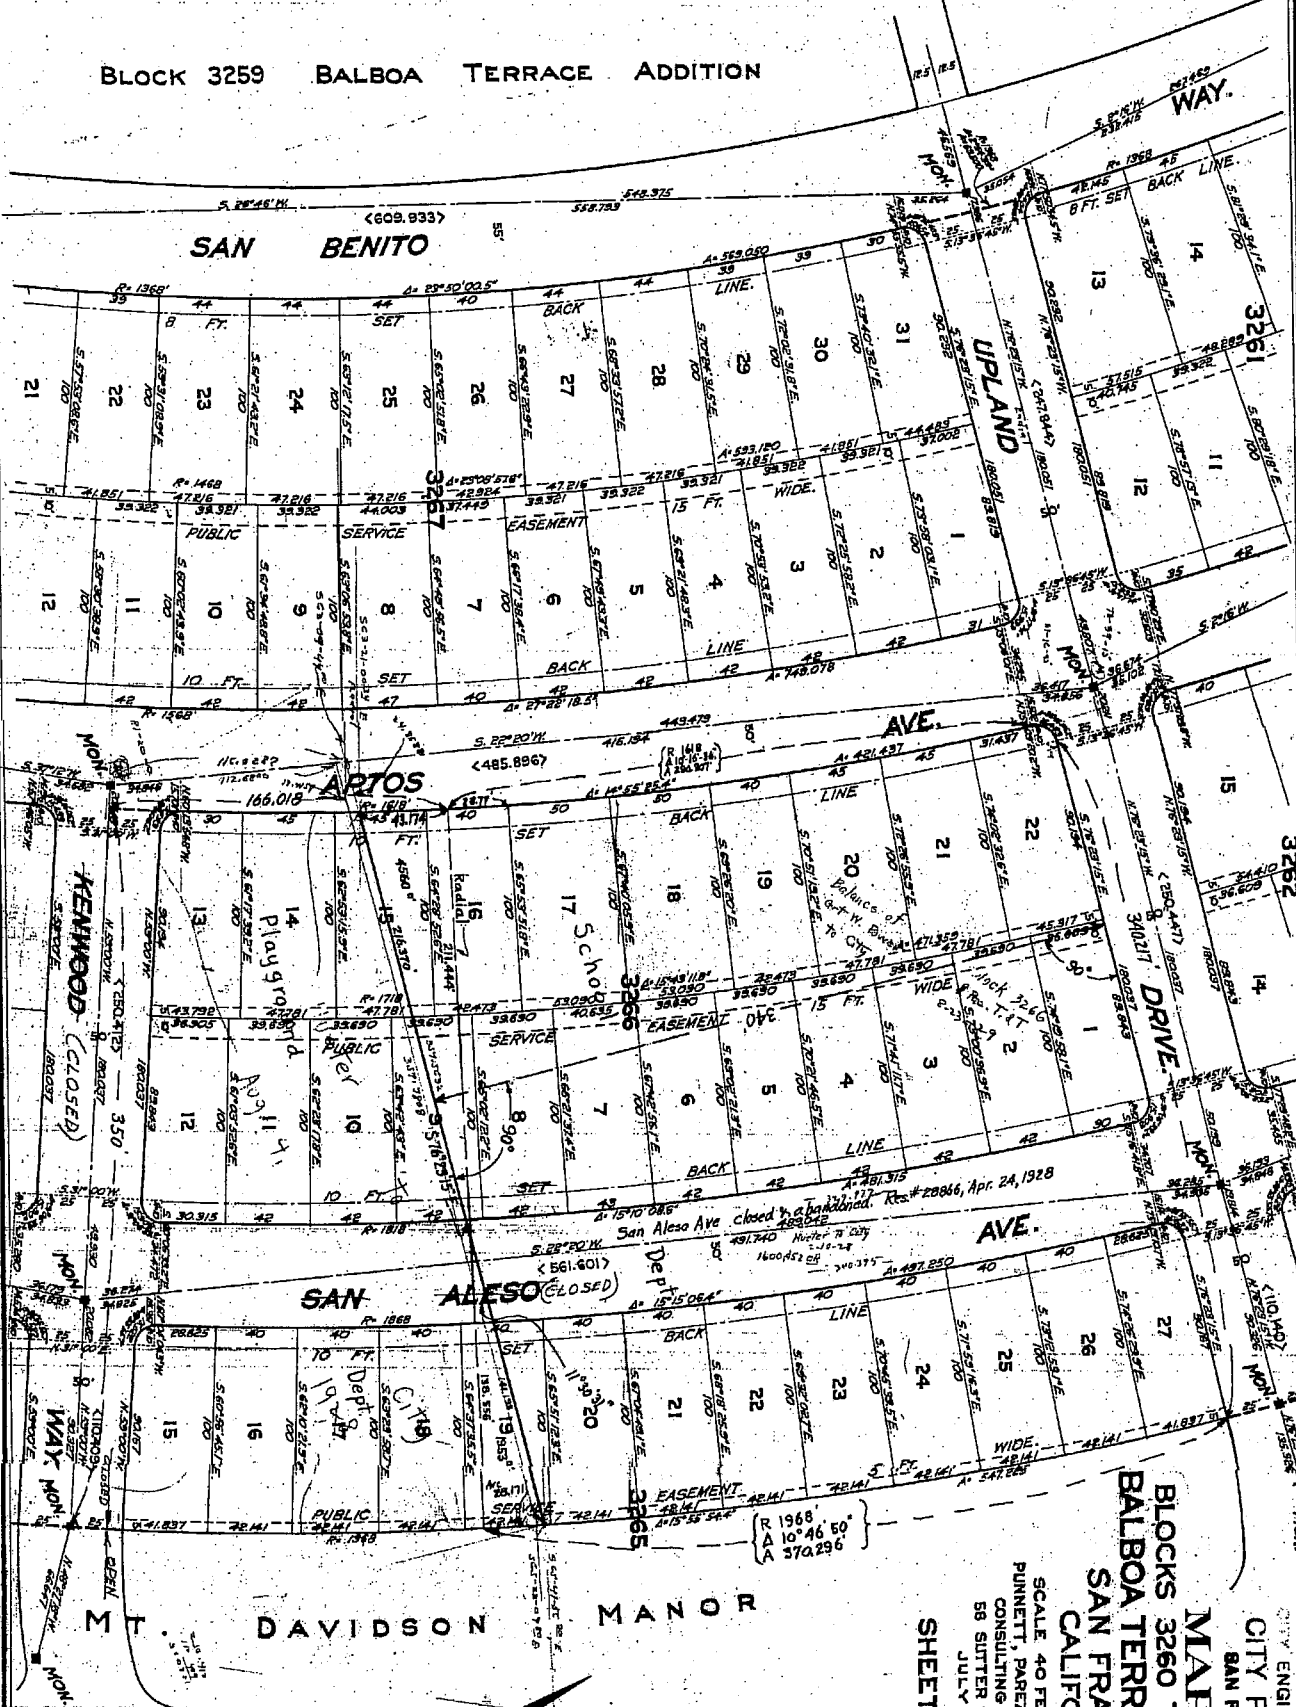

OFFICE COPY

CITY ENGINEERS OFFICE
 CITY PROPERTY
 SAN FRANCISCO

MAP OF
 BLOCKS 3260 TO 3269, INCL.
 BALBOA TERRACE ADDITION
 SAN FRANCISCO
 CALIFORNIA


SCALE 40 FEET TO 1 INCH
 PUNNETT, PAREZ & HUTCHISON
 CONSULTING ENGINEERS
 58 SLITTER ST. S.F. CAL.
 JULY, 1926.

SHEET NO. 2.

Red-lined by public 1-24-30
 See 2855 2845
 613-779-

BLOCK 3259

BALBOA TERRACE ADDITION

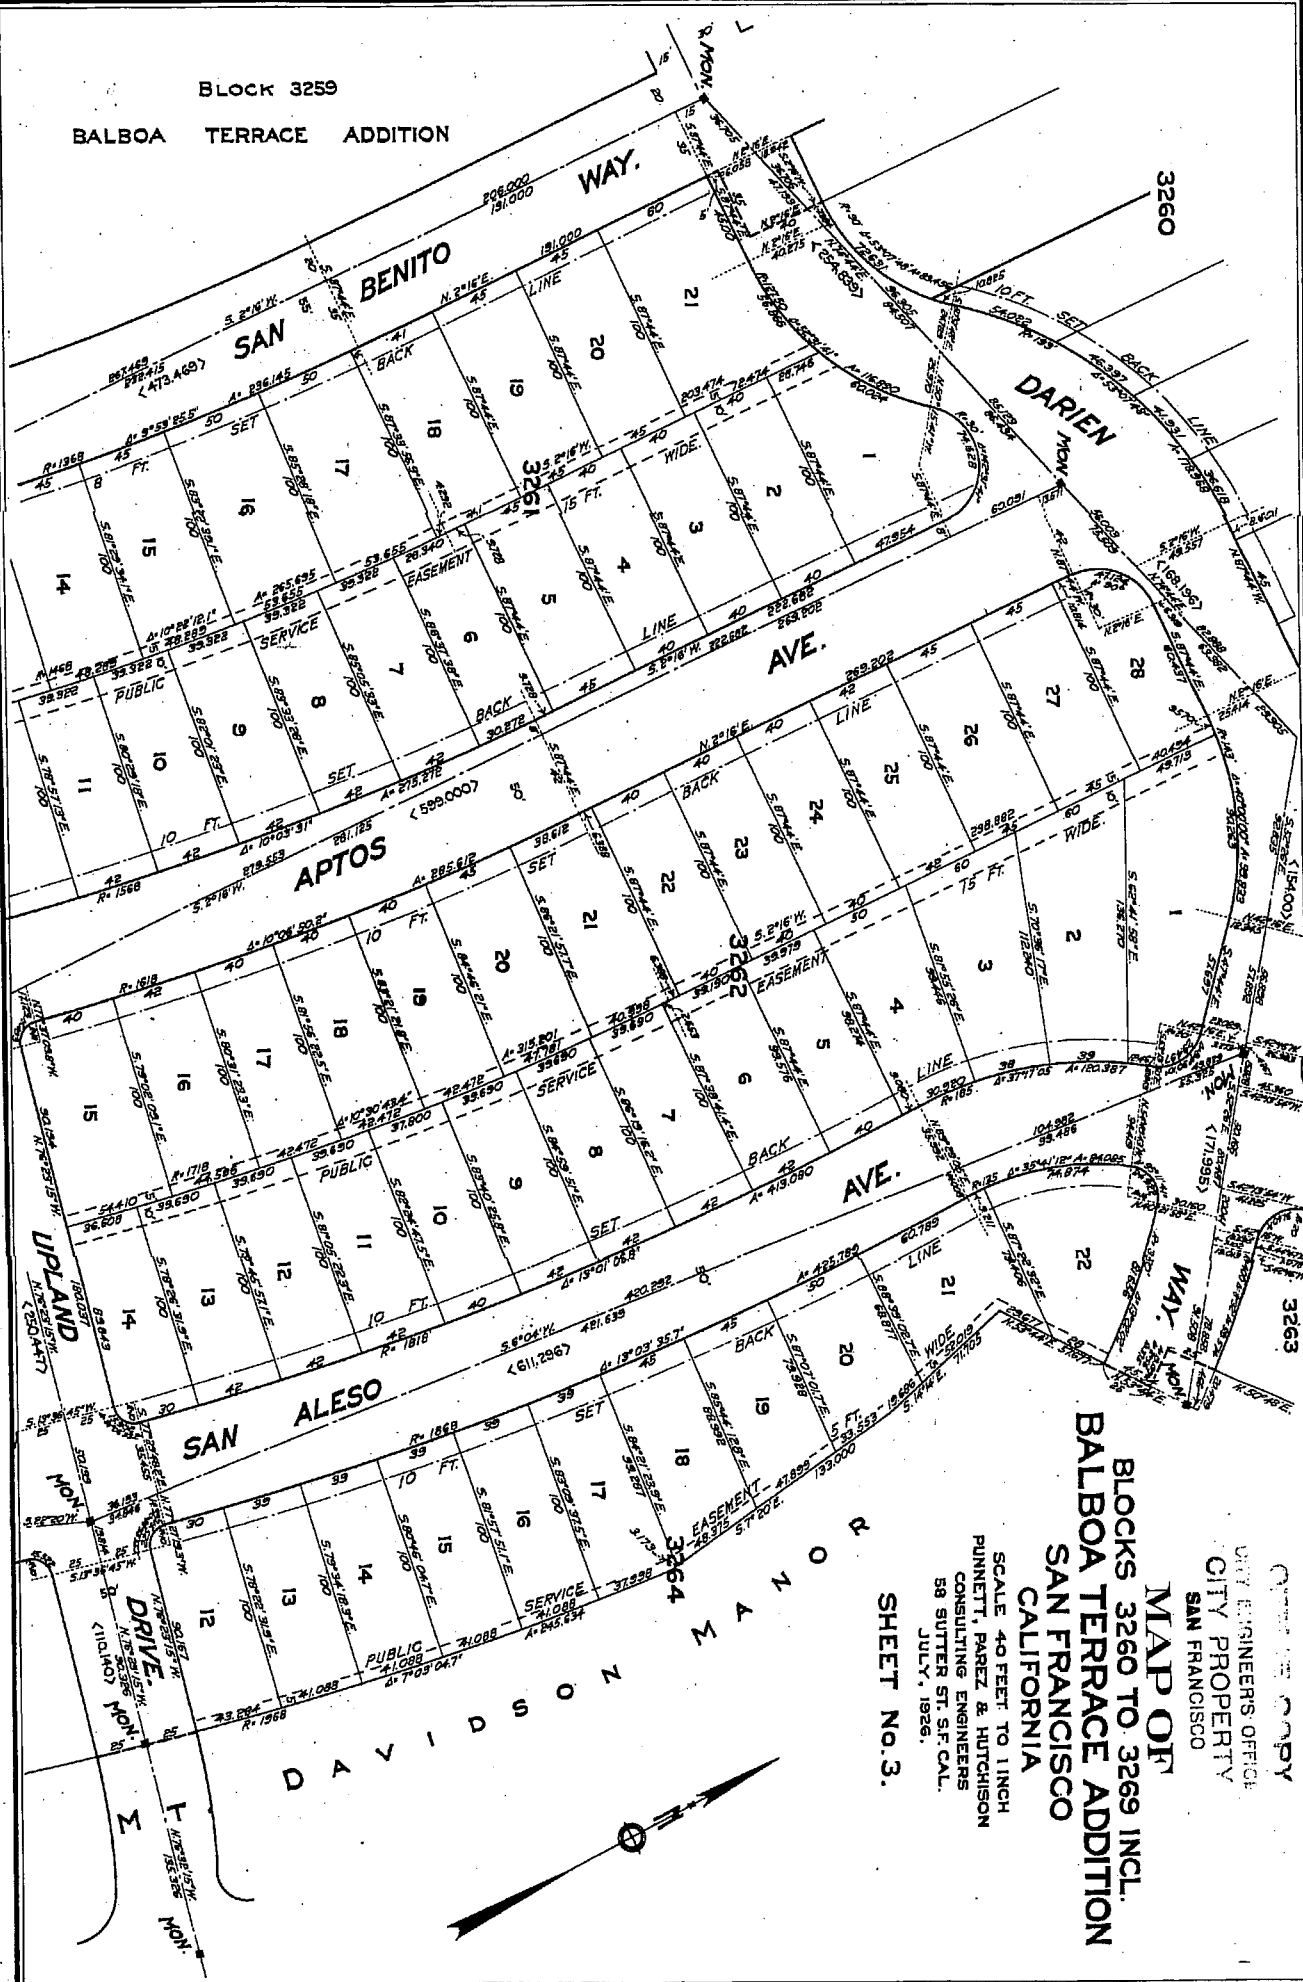

OFFICIAL COPY
 CITY ENGINEER'S OFFICE
 CITY PROPERTY
 SAN FRANCISCO
MAP OF
BLOCKS 3260 TO 3269 INCL.
BALBOA TERRACE ADDITION
SAN FRANCISCO
CALIFORNIA
 SCALE 40 FEET TO 1 INCH
 PUNNETT, PAREZ & HUTCHISON
 CONSULTING ENGINEERS
 58 SUTTER ST. S.F. CAL.
 JULY, 1926.
SHEET NO. 3.